

P-302A.B
TRUCK UNLOADING
PUMP

X-314
LIQUID TRAP



A


B

C

A

B

C

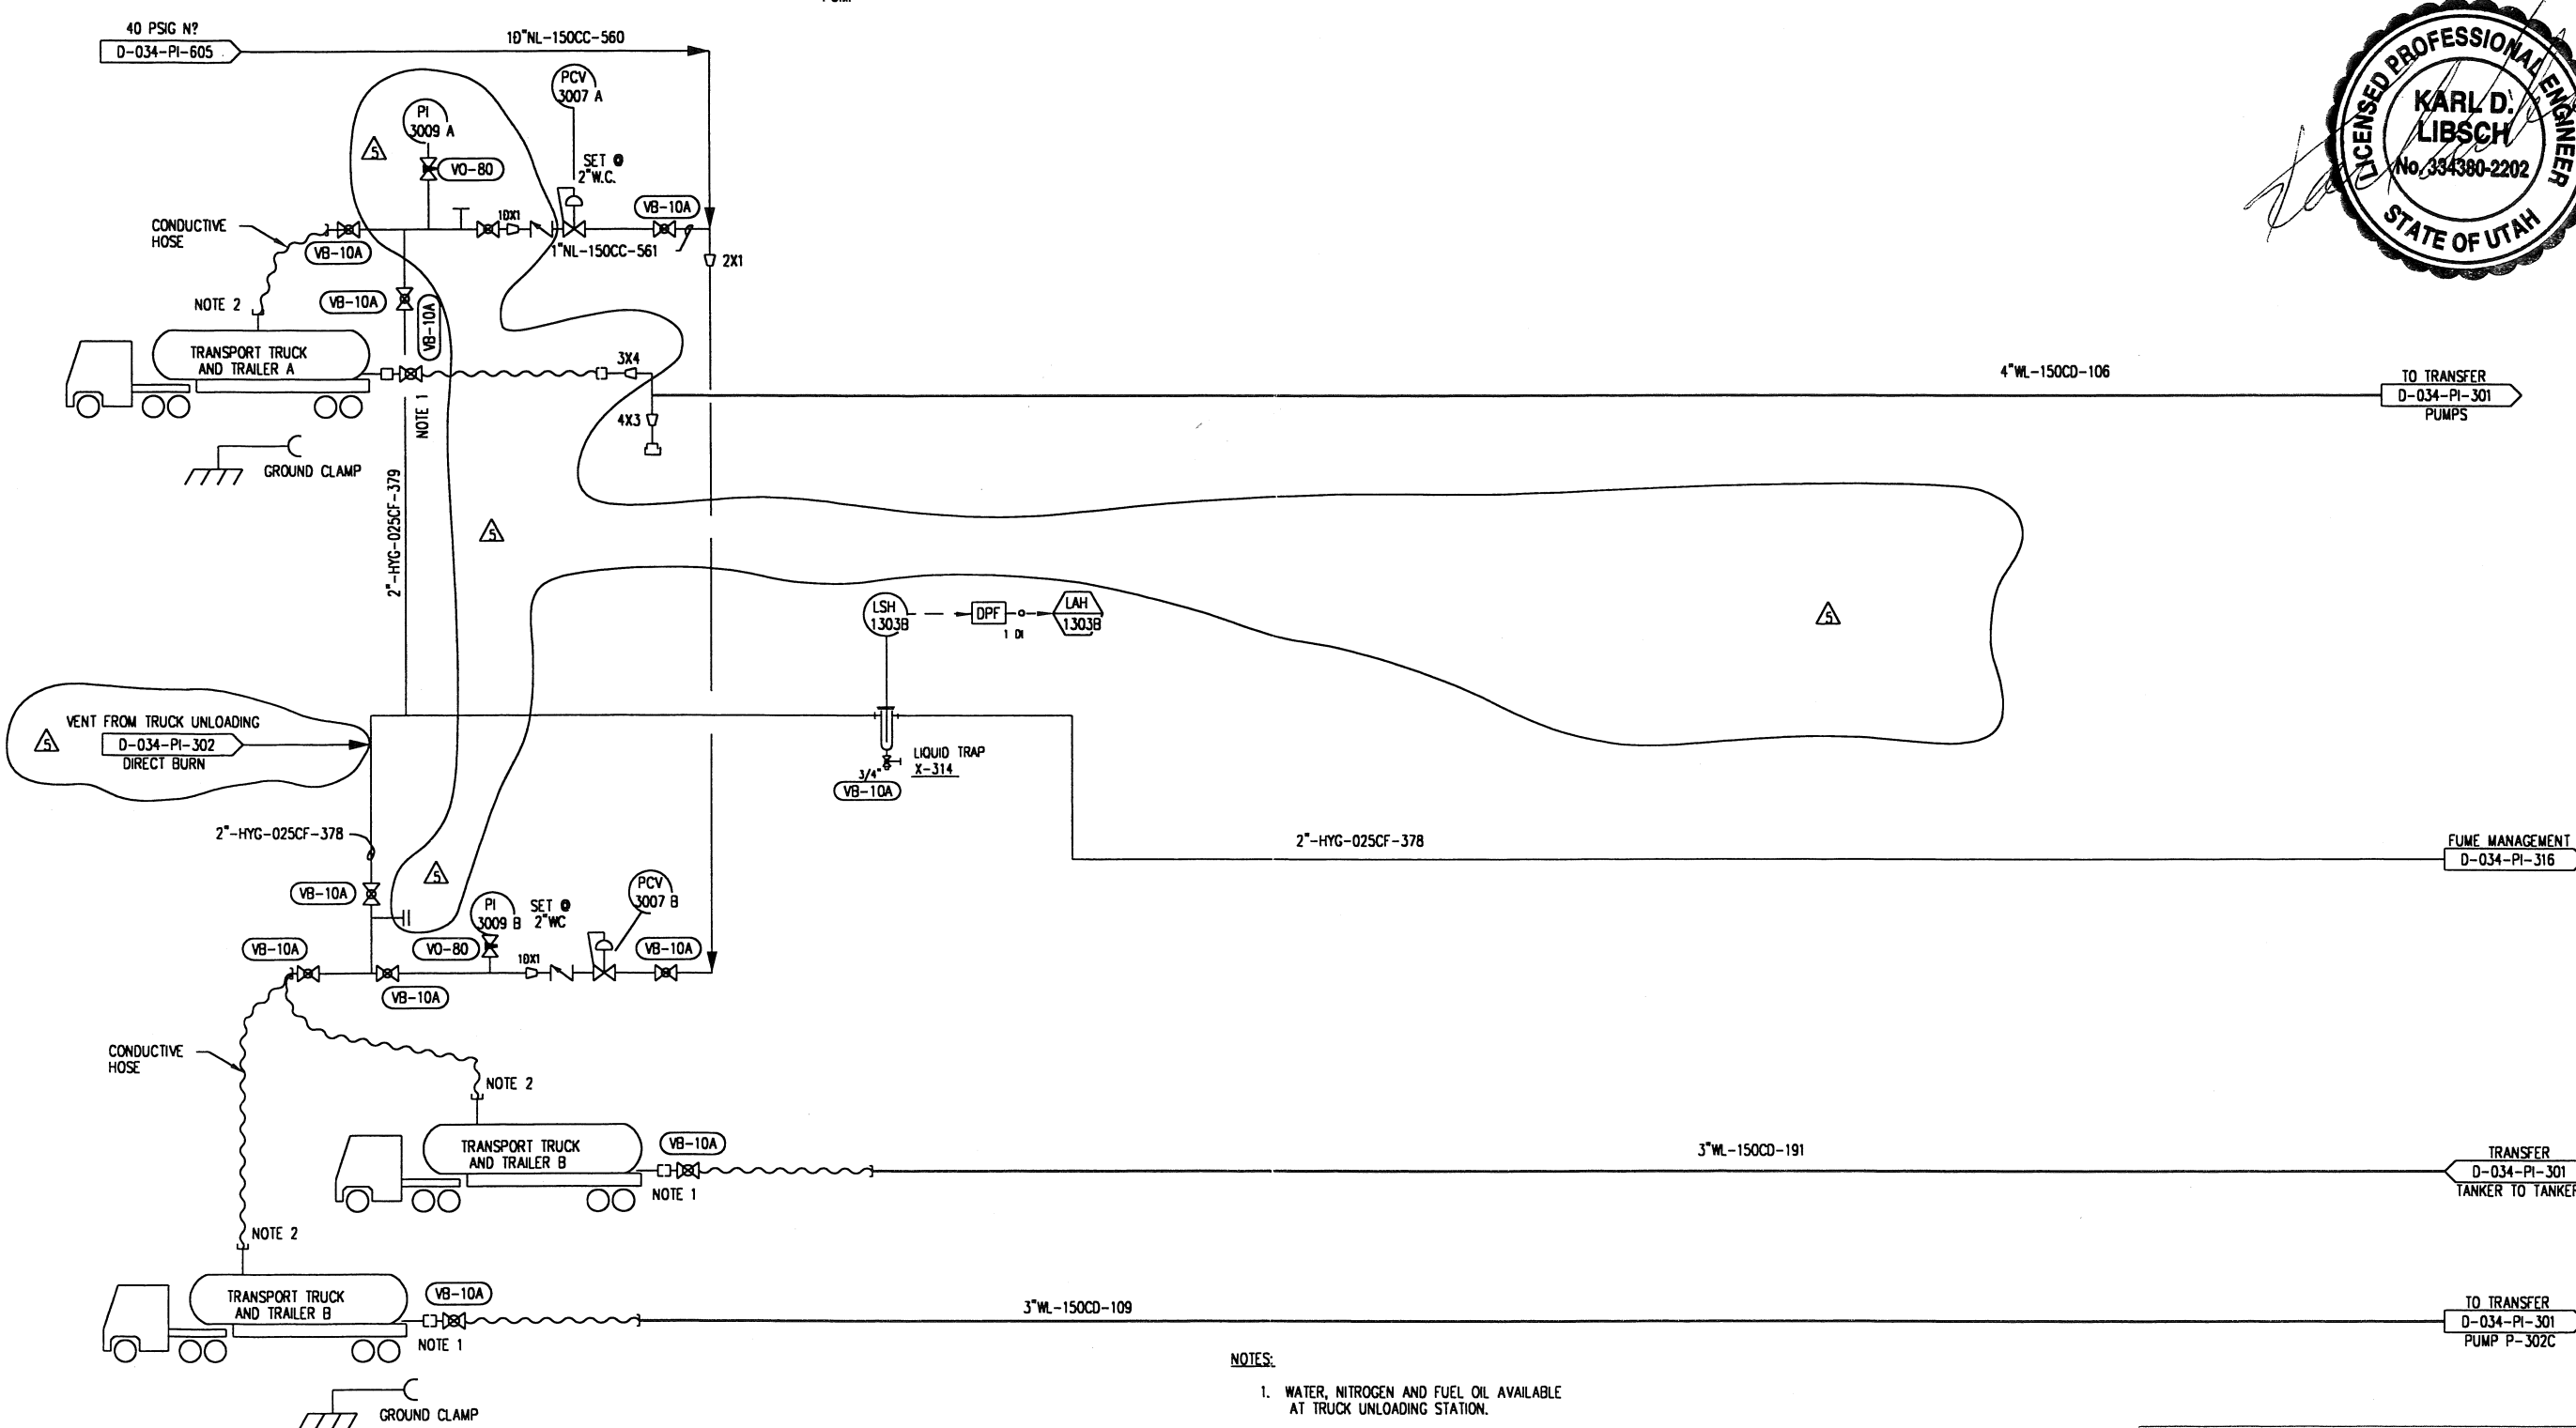

- NOTES:
- 1. WATER, NITROGEN AND FUEL OIL AVAILABLE AT TRUCK UNLOADING STATION.
 - 2. NITROGEN PURGE BY HOSE, IF REQUIRED BY OPERATING PROCEDURES.

INTERLOCK		REVISIONS										REFERENCE DRAWINGS		APPROVALS		CURRENT DRAWING STATUS		CONSULTING ENGINEER			
DESCRIPTION		NO	DESCRIPTION	BY	CHK	LEAD ENG	ELEC	MECH	STR	PROJ ENG	PROJ MGR	DRAWING NO	TITLE	BY	DATE	BY	DATE	SAFETY-KLEEN (ARAGONITE), INC. 11600 NORTH APTUS ROAD, ARAGONITE, UT. 84029			
		0	ISSUED FOR CONSTRUCTION	07/07/89	MU									CRM	2-30-96	KRP	2-17-88	UTAH ENVIRONMENTAL SERVICE CENTER TRUCK UNLOADING AREA P&ID LIQUID UNLOADING PUMPS			
		1	AS BUILT	03/13/91	AO													FOR APTUS			
		2	AS BUILT	12-30-96	CRM													SCALE NONE			
		3	AS BUILT	9-20-00	GVC													JOB NO W6068R			
		4	ADDED TRANSFER TANKER	4-11-01	GVC													ENG. DWG NO			
		5	TO TANKER															APTUS DWG NO			
		6	ADDED TANKER DIRECT BURN	09-13-02	KL													D-034-PI-300			
		7	AND REMOVED A-301															REV 5			